


LEGEND:

- PROPERTY BOUNDARY
- EXTENT OF SITE WORKS
- GRAVE / PLOT SITES
- PAVEMENT SUB SOIL DRAIN
- GRAVE SITE SUB SOIL DRAIN
- PAVEMENT
- 125mm OD, PN12.5 WATER MAIN
- WATER TAP
- EXISTING WATERCOURSE
- SUBSOIL RODDING EYE

- GENERAL NOTES:**
- ALL DIMENSIONS IN METRES UNLESS OTHERWISE STATED.
 - THE CONTRACTOR IS TO CHECK AND VERIFY ALL DIMENSIONS ON SITE PRIOR TO COMMENCEMENT OF CONTRACT. THE CONTRACTOR SHALL NOTIFY THE ENGINEER IF THERE ARE ANY DISCREPANCIES OR AMBIGUITIES.
 - THE CONTRACTOR IS TO CONFIRM THE LOCATION OF SERVICES UNDERNEATH THE EARTHWORKS FOOTPRINT, IF THE EXISTING SERVICES CONFLICT WITH THE PROPOSED WORKS THEN THE ENGINEER WILL NEED TO BE NOTIFIED IMMEDIATELY.
 - PIPE, CABLES AND OTHER UTILITIES, FOUNDATIONS, LEVELS, REFERENCE MARKS AND OTHER OBSTRUCTIONS INDICATED ON THIS DRAWING ARE BASED ONLY ON READILY AVAILABLE RECORD PLANS AND OTHER INFORMATION. THIS INFORMATION MAY NOT BE COMPLETE, ACCURATE NOR UP TO DATE. PRIOR TO CARRYING OUT ANY EXCAVATIONS OR OTHER PHYSICAL WORK THE CONTRACTOR SHALL OBTAIN THE LATEST INFORMATION FROM UTILITY PROVIDERS AND CARRY OUT DETAILED EXPLORATORY WORK, TRACING, LOCATING, PROTECTION, ISOLATION AND ALTERATIONS AS REQUIRED UNDER NZS 3910:2013 CLAUSE 5.1.3.

Stage 1			
PLOT	PLOT TYPE	GRAVE No.	SITE MAX GRADES
A	DOUBLE	240	13%
B	DOUBLE	400	6%
O	DOUBLE	640	13%
		Stage 1 total =	1280
Stage 2			
PLOT	PLOT TYPE	GRAVE No.	SITE MAX GRADES
C	DOUBLE	320	13%
D	SINGLE	160	15%
E	DOUBLE	320	10%
F	SINGLE	160	16%
G	DOUBLE	480	18%
H	SINGLE	160	13%
I	DOUBLE	320	12%
J	SINGLE	240	17%
K	SINGLE	300	20%
L	SINGLE	300	14%
M	SINGLE	600	18%
		Stage 2 total =	3360
		Grand Total	4640

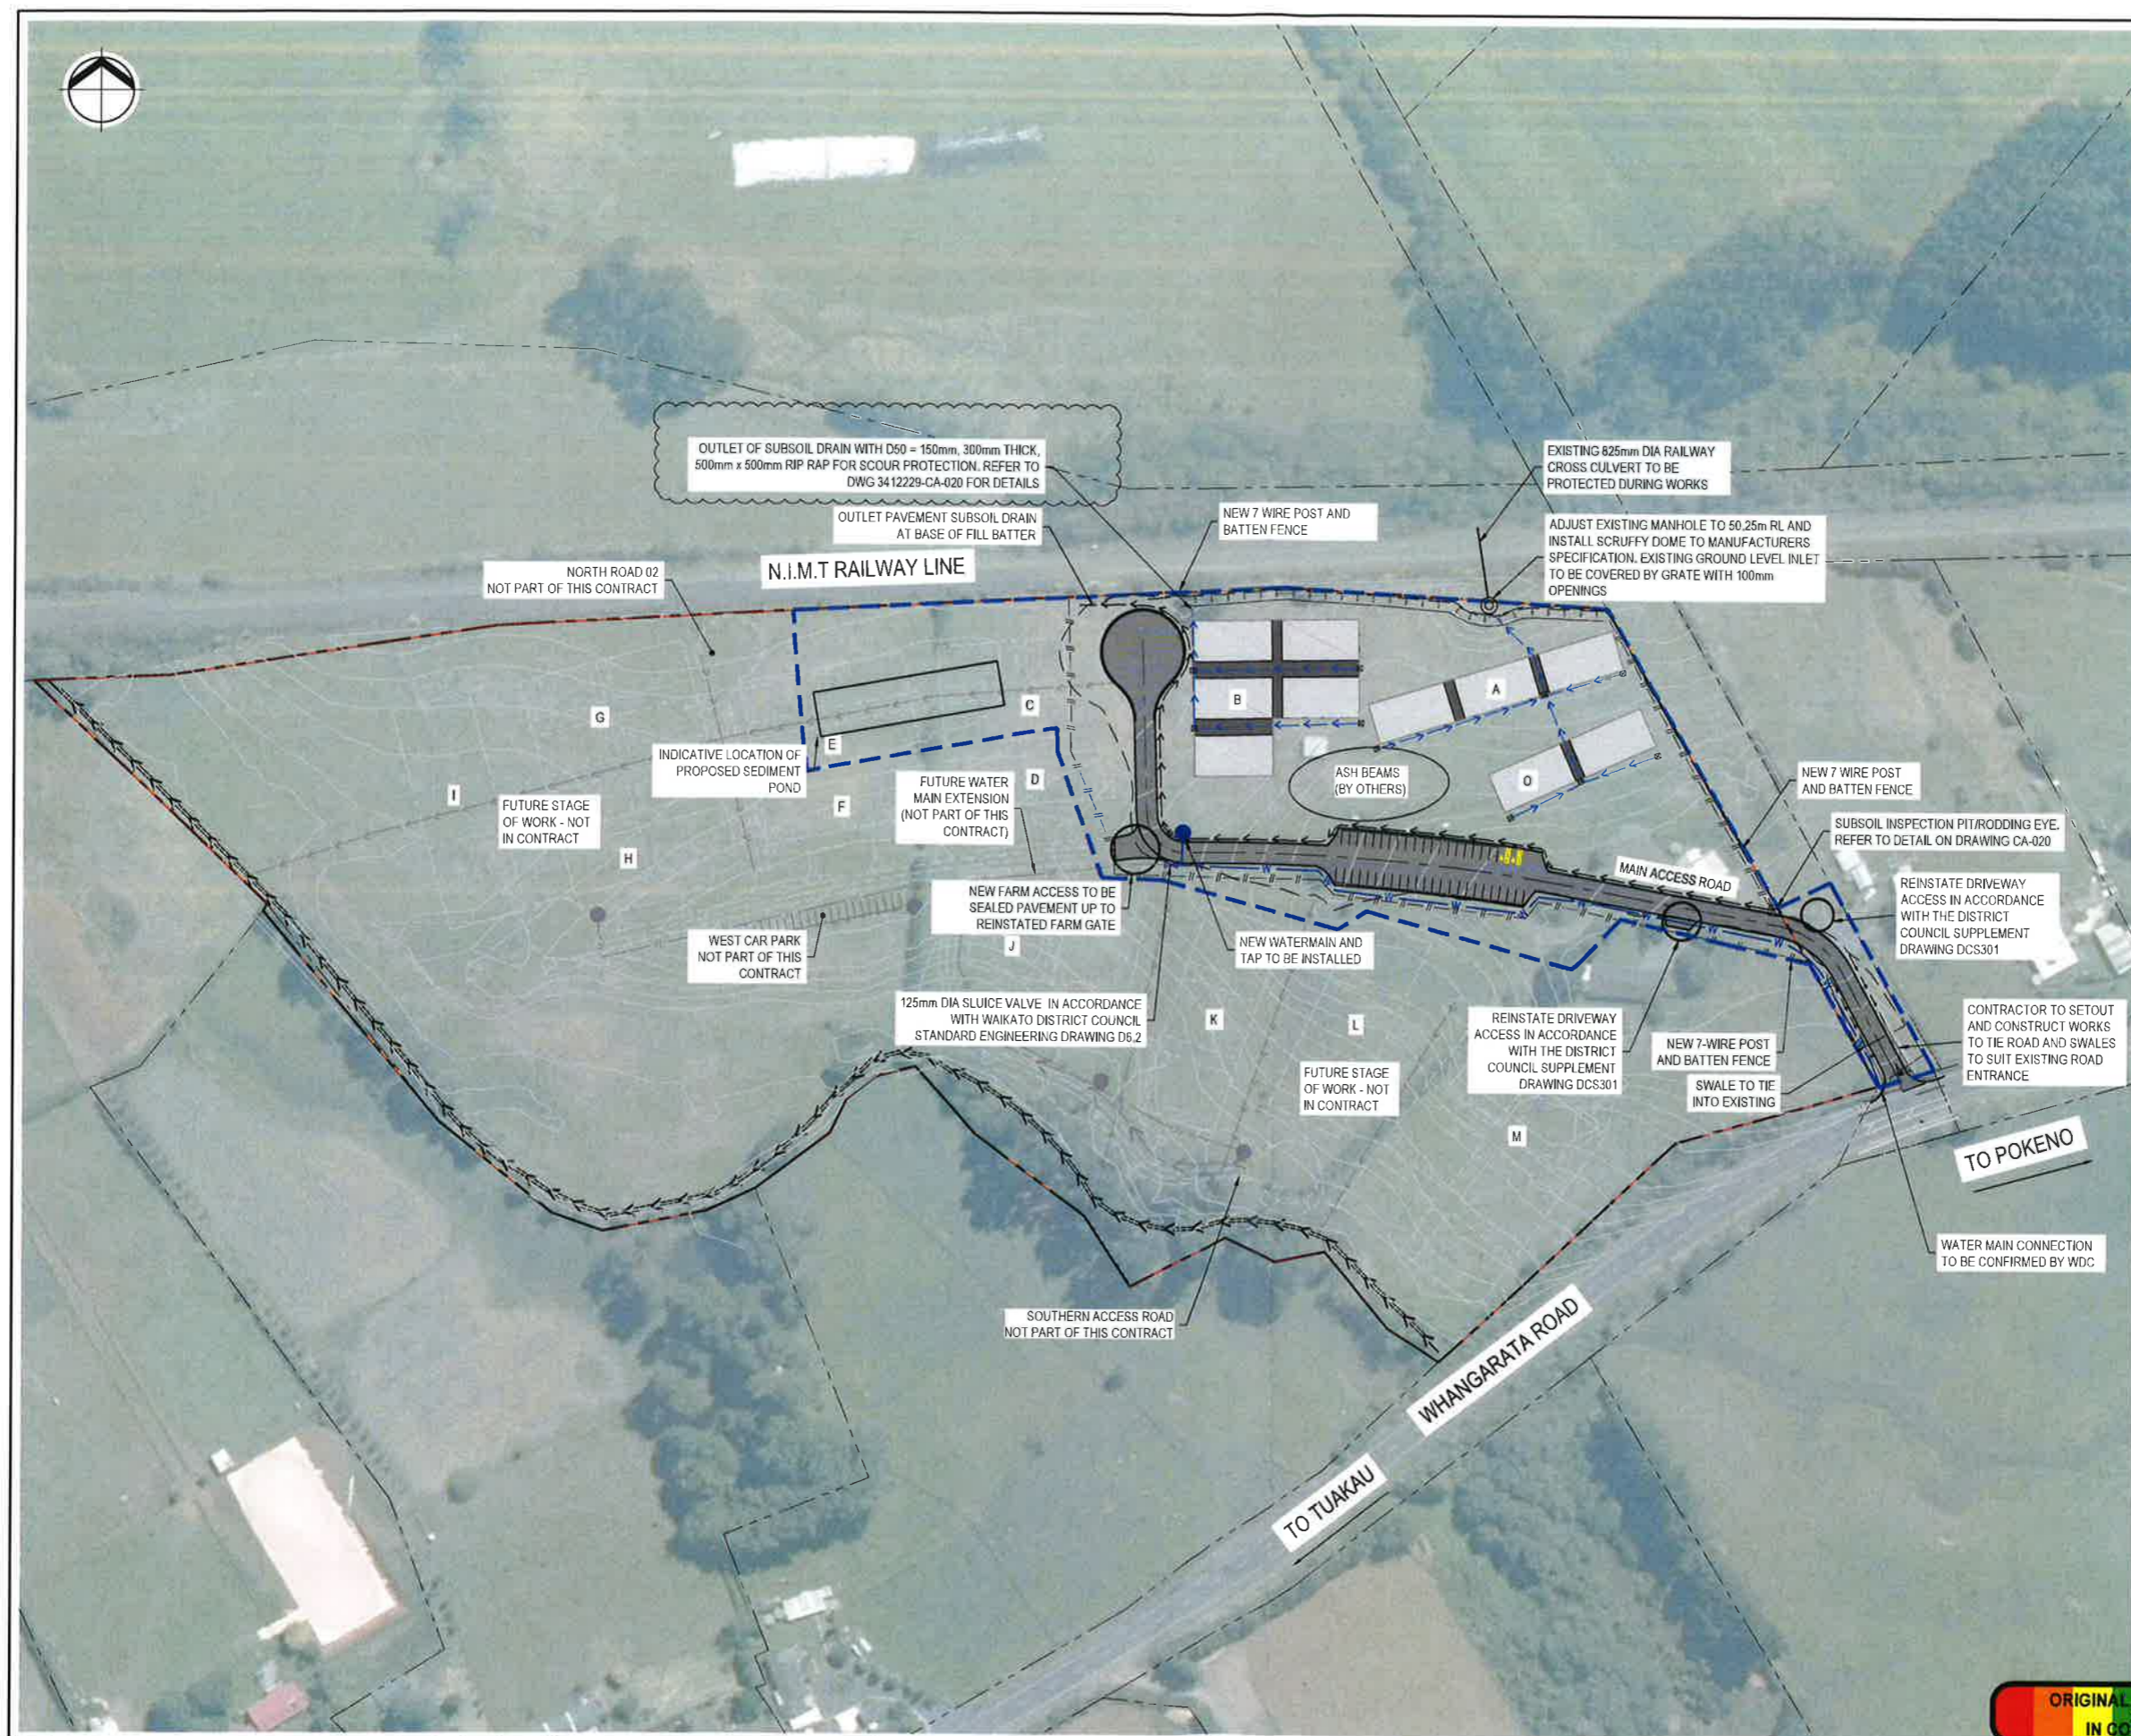

No.	Revision	By	Chk	Appt	Date
2	FOR CONSTRUCTION	SH	GC	GC	29.01.19
1	FOR CONSTRUCTION	MH	GC	GC	25.10.19
0C	FOR CONSENT	PP	GC	GC	16.08.18
0B	MAINHOLE LEVEL UPDATED	SH	GC	GC	02.05.18

Beca

Drawing Originator

Design	AWS	18.02.16	Approved For Construction*
Drawn	AWS	18.02.16	GC
Dig Verifier	CJM	19.12.16	
Dig Check	GB	19.12.16	Date: 25.10.19

Original Scale (A1) 1:1000
Reduced Scale (A3) 1:2000

* Refer to Revision 1 for Original Signature

Client: **Waikato District Council**

Project: **FUTURE TUAKAU / POKENO CEMETERY DEVELOPMENT STAGE 1**

Title: **GENERAL ARRANGEMENT PLAN**

Discipline: **CIVIL ENGINEERING**

Drawing No.: **3412229-CA-005**

Rev: **2**

ORIGINAL DRAWING IN COLOUR

FOR CONSTRUCTION